

**SCDHEC OFFICE OF OCEAN AND COASTAL RESOURCE MANAGEMENT
PERMIT APPLICATION PUBLIC NOTICE**

May 4, 2007

Permit Number: OCRM-07-850
Permit ID: 58607

The SCDHEC Office of Ocean and Coastal Resource Management has received an application for a permit for the alteration of a critical area. This application was submitted pursuant to the Coastal Zone Management Act (Act 123) of the 1977 South Carolina General Assembly. The application, in brief, is described as follows:

APPLICANT: Robert Riddell
C/o Bailey Marine Construction Inc
277 Old Baileys Rd
Okatie SC 29909

LOCATION: On and adjacent to a tributary of the Okatie River at 52 Winding Oak Drive on Callawassie Island, Okatie, Beaufort County, South Carolina.
TMS#: R600-015-00A-0019-0000.

WORK: The work proposed consists of making additions to an existing private dock. Proposed is a 12'x12' 4 pile boatlift off the right of an existing 7'x7' fixed pierhead. The purpose for the dock addition will be for the owner's private recreational use.

This public notice is being distributed to all known interested persons and agencies to assist in developing facts on which a decision by OCRM can be based. Comments concerning the proposed work should be submitted in writing, setting forth sufficient detail to furnish a clear understanding of the reasons for support or opposition.

The decision to issue or deny a permit will be based on the individual merits of the application, the policies specified in the South Carolina Coastal Zone Management Act, and the considerations outlined in the State of South Carolina Coastal Zone Management Program. Interested parties who wish to be notified of final permit action must notify OCRM in writing of this request.

To assure review by OCRM, comments regarding this application must be received by OCRM on or before May 19, 2007


PLEASE REPLY TO:

SCDHEC OFFICE OF OCEAN AND COASTAL RESOURCE MANAGEMENT
104 Parker Drive
Beaufort, South Carolina 29906

Please refer to P/N# OCRM-07-850


G. J. Madlinger, III, Project Manager

DOCK AS-BUILT/PERMIT
PREPARED FOR
ROBERT RIDDELL

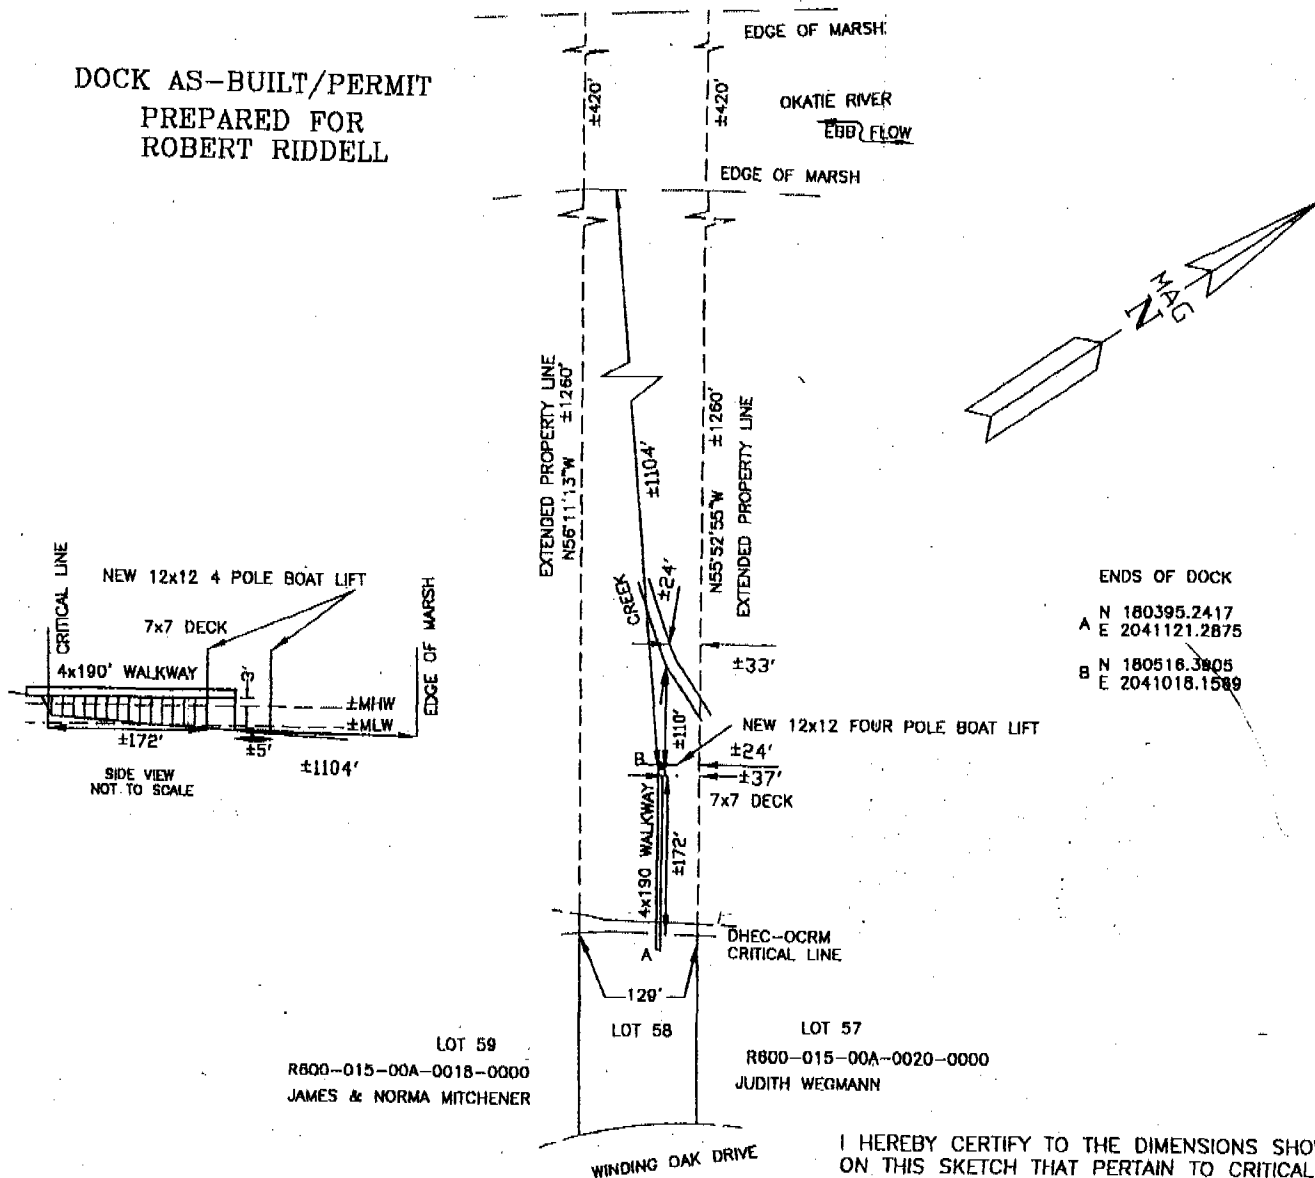

ENDS OF DOCK

N 180395.2417
E 2041121.2875
B N 180518.3805
E 2041018.1589

I HEREBY CERTIFY TO THE DIMENSIONS SHOWN
ON THIS SKETCH THAT PERTAIN TO CRITICAL LINE
AND MARSH LINE.

PIN: R600-015-00A-0019-0000

0 100' 200' 400' 600'

SCALE 1" = 200'

MARCH 15, 2007
P13257/JJ

OCRM-07-850

David S. Youmans
DAVID S. YOUMANS RLS 9765
BEAUFORT SURVEYING, INC.
1613 PARIS AVENUE
PORT ROYAL, S.C. 29935
PHONE (843) 524-3261

APPLICANT: ROBERT RIDDELL

LOCATION: CALLAWASSIE ISLAND

ADJACENT PROPERTY OWNERS


ACTIVITY: DOCK AS-BUILT
PROPOSED BOAT LIFT

COUNTY: BEAUFORT

JAMES & NORMA MITCHENER
54 WINDING OAK DRIVE

DATE: 03/15/07

JUDITH WEGMANN
50 WINDING OAK DRIVE

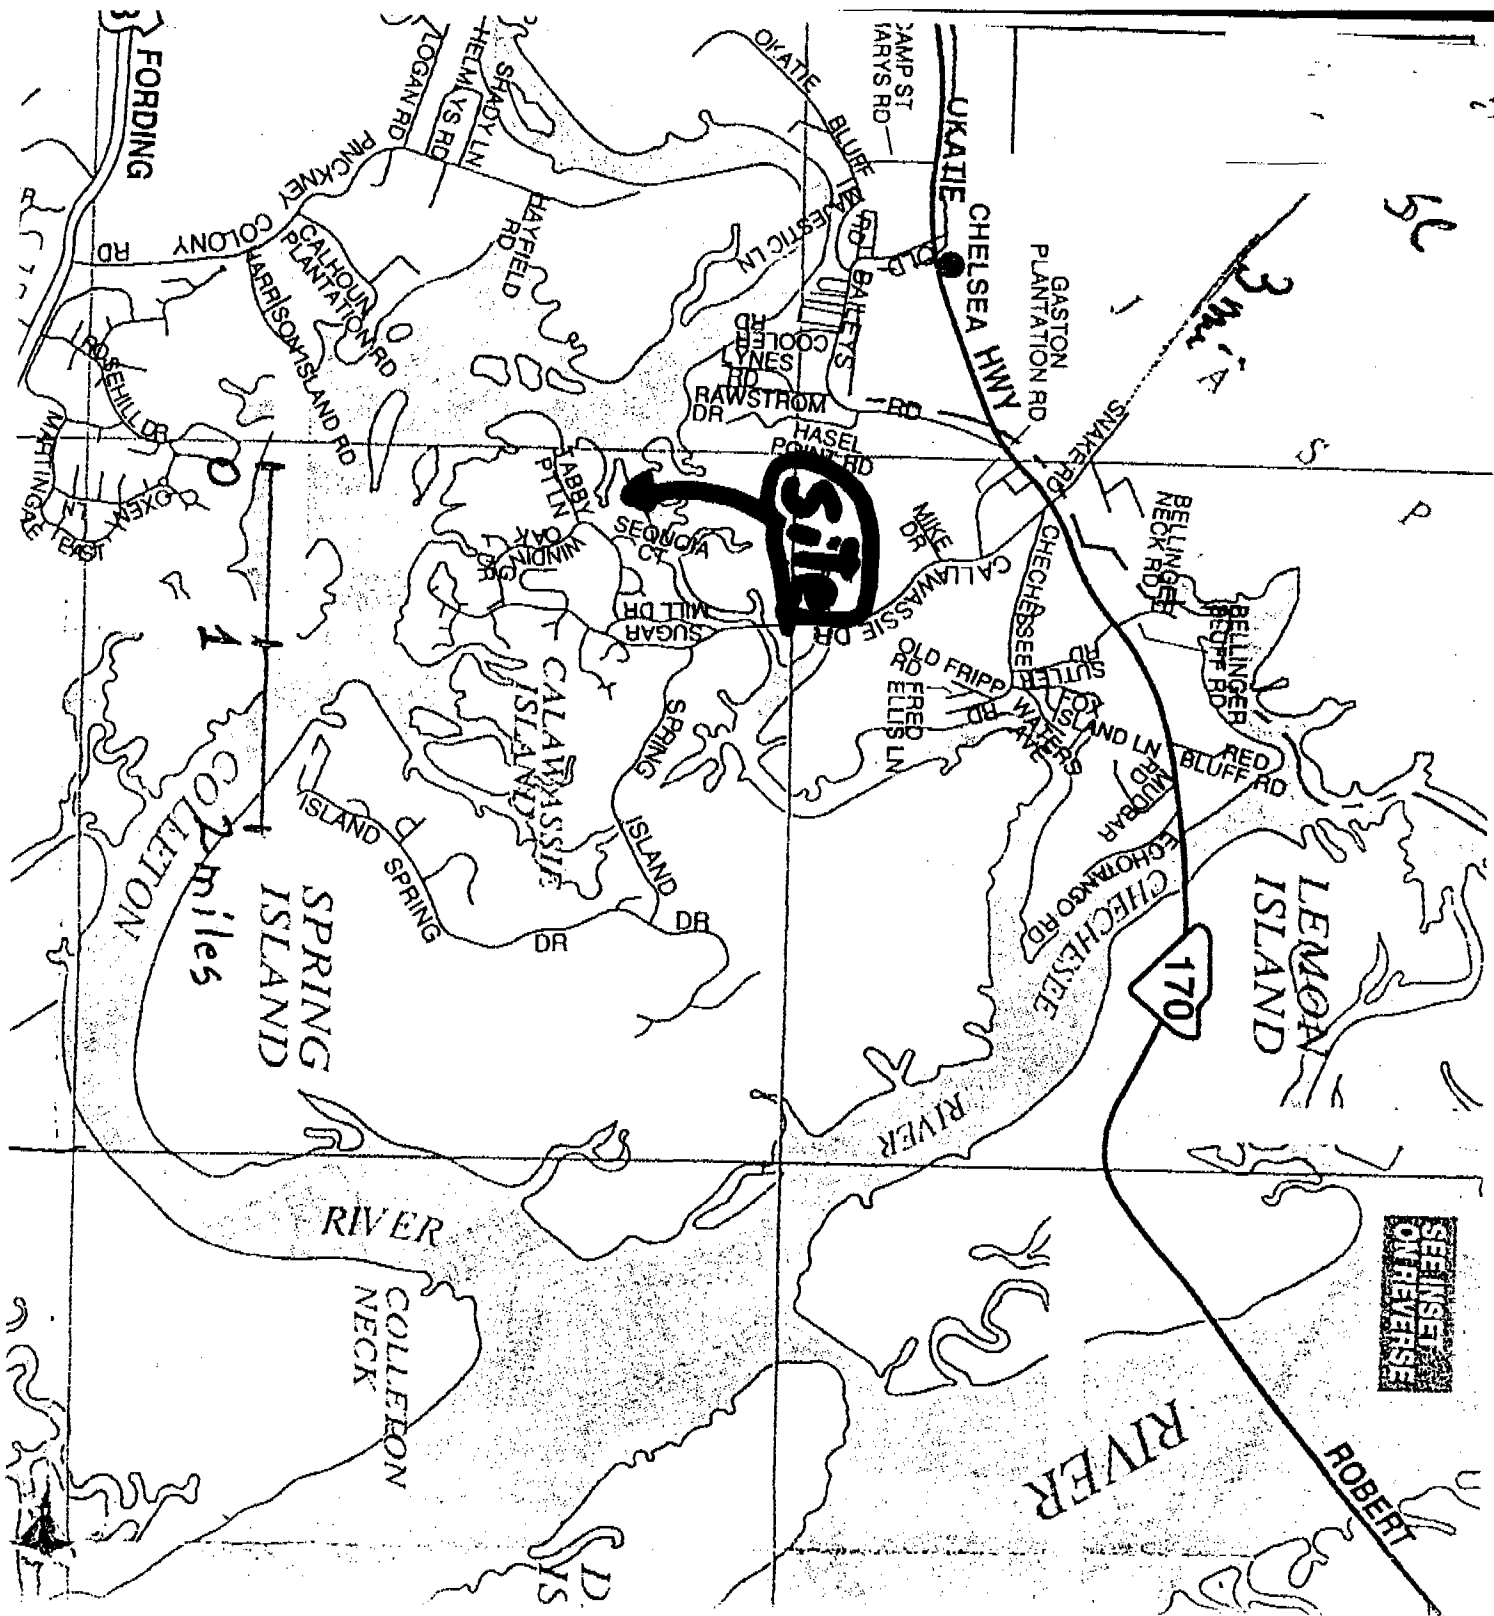

OCRM-07-850

<p>APPLICANT: ROBERT RIDDELL</p>	<p>LOCATION: CALLAWASSIE ISLAND</p>	<p>ADJACENT PROPERTY OWNERS</p>
<p>ACTIVITY: DOCK AS-BUILT PROPOSED BOAT LIFT</p>	<p>COUNTY: BEAUFORT DATE: 03/15/07</p>	<p>JAMES & NORMA MITCHENER 54 WINDING OAK DRIVE JUDITH WEGMANN 50 WINDING OAK DRIVE</p>